


P-536


PROJ. REFERENCE NO.	SHEET NO.	TOTAL SHEETS
9-8039055	49	
STATE PROJ. NO.	F.A. PROJ. NO.	DESCRIPTION

ELIMINATE CUT DITCH
STA 328+00 STA 333+00 LT.

FOR RC BOX CULVERT PLANS
SEE CULVERT PLANS C13-C15

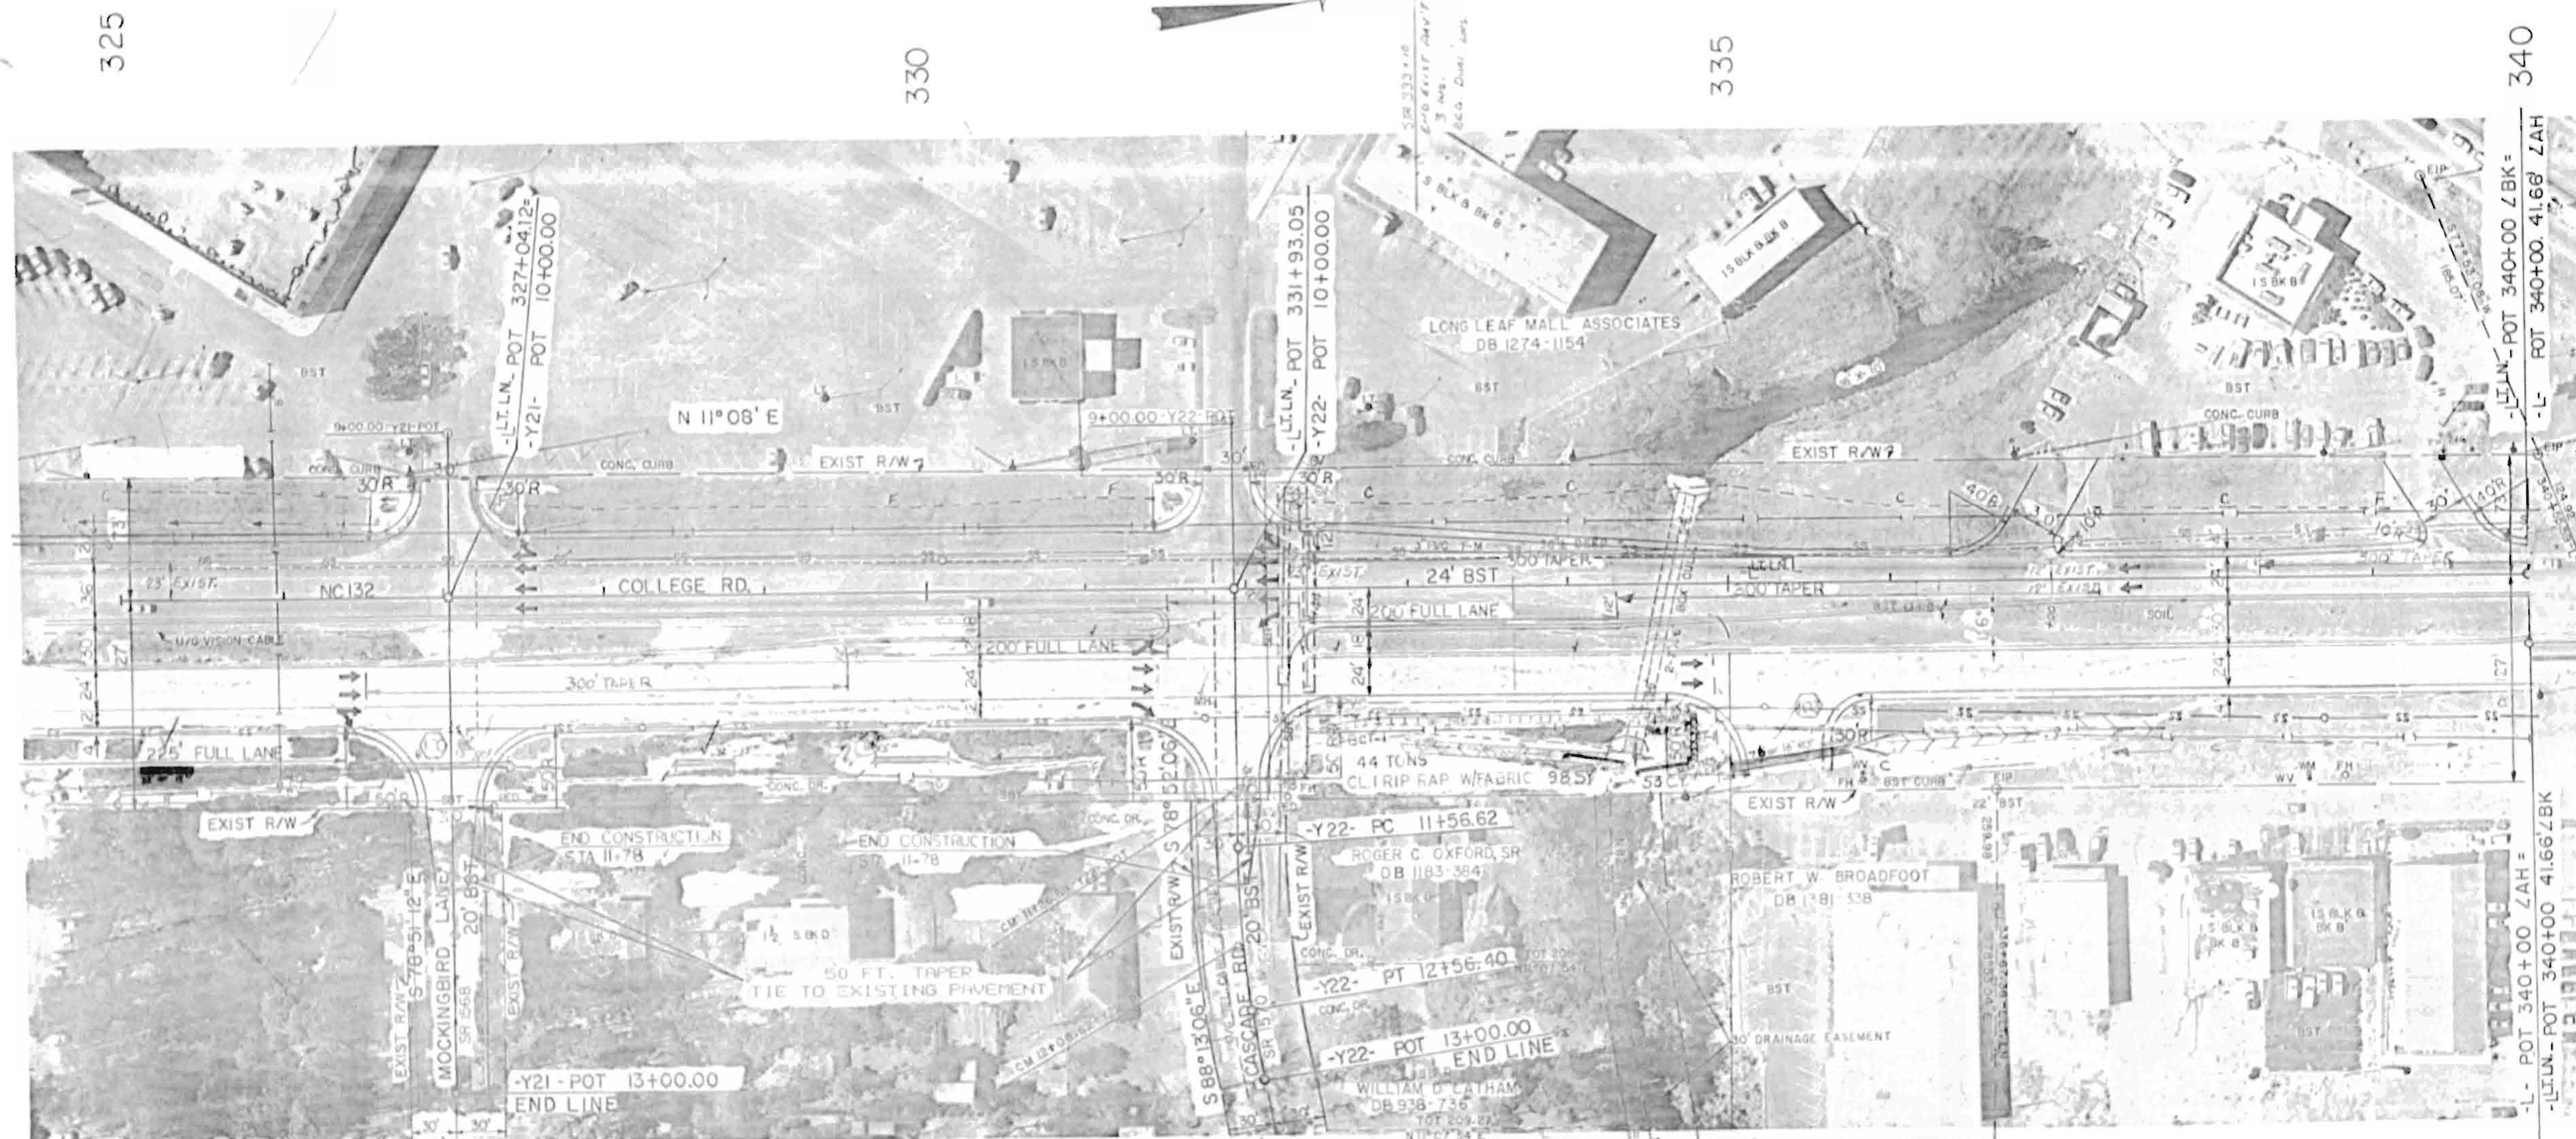

3200 5500		3300 5700	
2000 3400	1100 1900	600 1000	2500 4400
NC 132 18,500 35,100	300 500	200 300	17,500 33,400
1989 ADT 2009 ADT		100 200	
600 1000		SR 1569	
		600 1000	
		SR 1570	
		300 500	
		19,600 37,100	

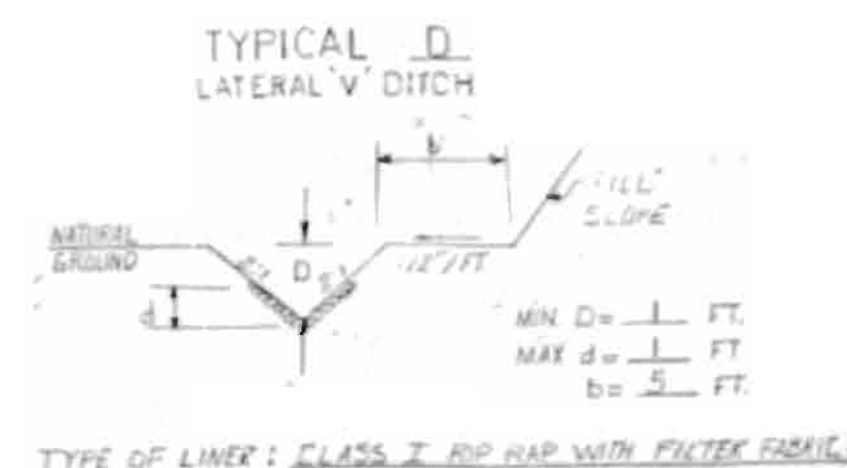

TYPICAL D
LATERAL V DITCH
STA 333+00 — BOX CULVERT RT.
2:1 SIDE SLOPE
S = 6.0%
NOTE: SEE PROFILE FOR DITCH GRADES

TYPICAL A
SPECIAL DITCH DETAIL
STA 336+00 — STA 338+00 PT.
S = 1.0%
FOR DETAIL SEE SHEET NO. 7
NOTE: SEE PROFILE FOR DITCH GRADES

-L- LT. LN. STA. 325+00 to STA. 340+00